NOTE:
SHOW GRID IS
3 FOOT SQUARE

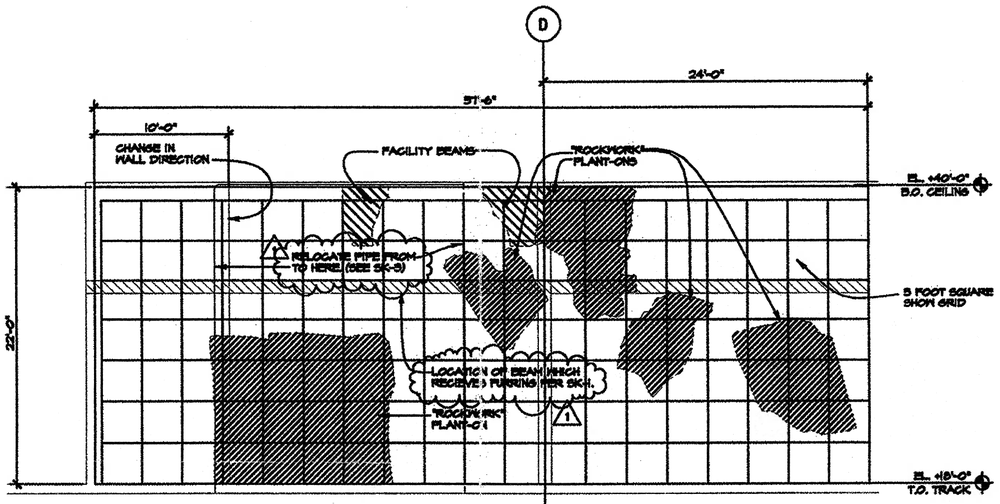

MURAL ELEVATION (DEVELOPED) M42
SCALE: 1/4"=1'0" D-8-01 | D-8-06

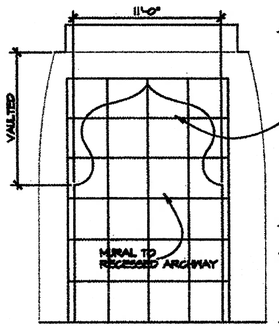

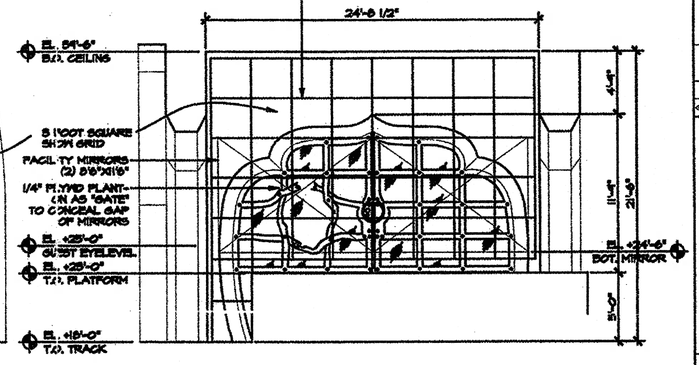

ELEVATION M39,40,41
SCALE: 1/4"=1'0" D-8-01 | D-8-06

ELEVATION M31
SCALE: 1/4"=1'0" D-8-02 | D-8-06

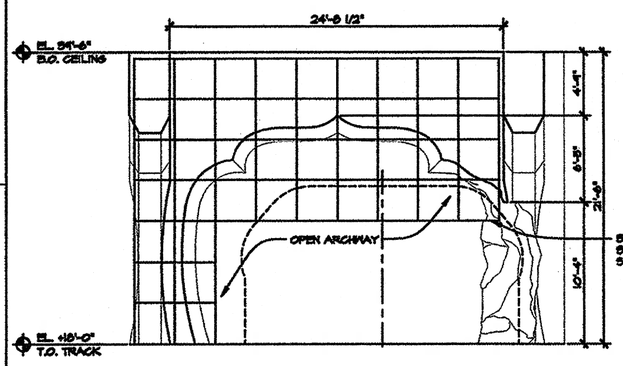

ELEVATION M34
SCALE: 1/4"=1'0" D-8-02 | D-8-06

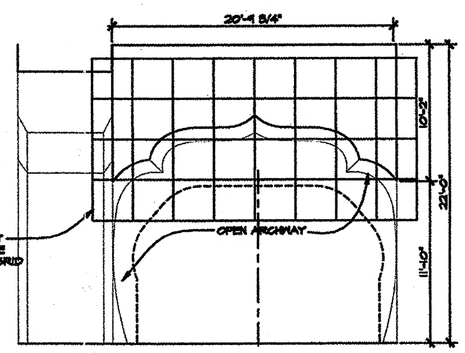

ELEVATION M36
SCALE: 1/4"=1'0" D-8-02 | D-8-06

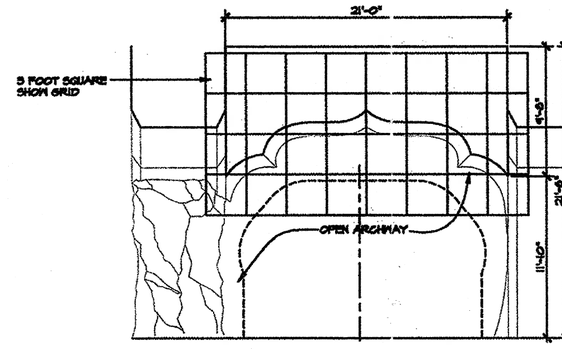

ELEVATION M35
SCALE: 1/4"=1'0" D-8-02 | D-8-06

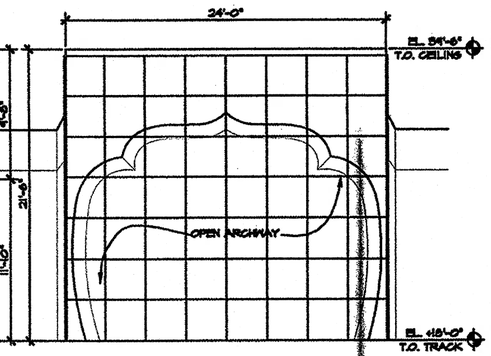

ELEVATION M37
SCALE: 1/4"=1'0" D-8-02 | D-8-06

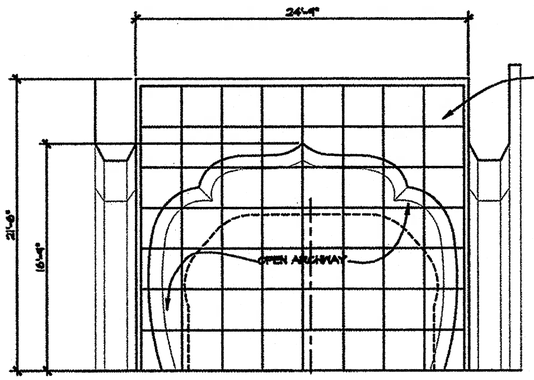

ELEVATION M32,33
SCALE: 1/4"=1'0" D-8-02 | D-8-06

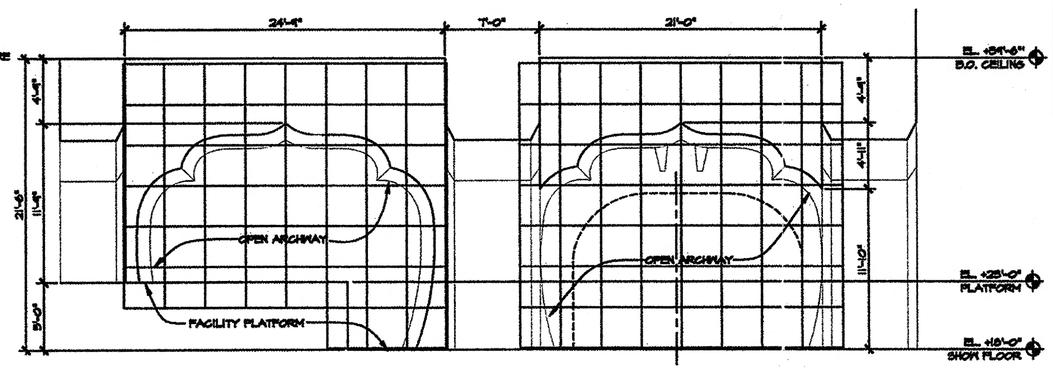

ELEVATION M30
SCALE: 1/4"=1'0" D-8-02 | D-8-06

ELEVATION M29
SCALE: 1/4"=1'0" D-8-02 | D-8-06

NOTES:

- ALL MURAL CANVASES TO OVERRUN DIMENSIONS ON SIDES AND TOP BY 12 INCHES. BLEED IMAGE OVER ENTIRE CANVAS.

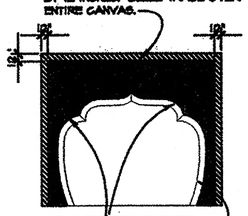

- MURAL FINISHES AT EDGE OF BEVELLED ARCH
- SCENIC PAINT TO BEVELLED ARCH.
- SEE CREATIVE FOR ALL ART AND LINE WORK.

GENERAL NOTES:

- SHOW SET DRAWINGS SERVE AS A COORDINATION TOOL DESCRIBING THE FORM AND DESIGN OF THE SHOW. FINAL FINISH AND CHARACTER IS DETERMINED BY THE ART DIRECTOR.
- REFER TO MODEL AND ILLUSTRATIONS FOR GENERAL ART DIRECTION AND INTENT (CHARACTER AND THEMING).
- REFER TO FACILITY DRAWINGS FOR CURRENT STRUCTURAL AND ARCHITECTURAL INFORMATION.

REV. NO.	REV. BY	DATE	DESCRIPTION OF REVISIONS
1		1/29/94	AS BUILT REVISION
2		12/10/93	95% RELEASE FOR PRODUCTION
3		9/24/93	FACILITY COMPLETION PACKAGE
4			ISSUED FOR
5			
6			
7			
8			
9			

NOTICES:
THE DATA IN THIS DOCUMENT INCORPORATE PROPRIETARY RIGHTS OF WALT DISNEY IMAGINEERING, 1401 FLORES STREET, BURBANK, CALIFORNIA 91521, UNITED STATES OF AMERICA. ANY REPRODUCTION, DISCLOSURE, CONFERENCE AND ACCESS THAT IT SHALL NOT BE EMPLOYED, IN WHOLE OR IN PART, WITHOUT SPECIFIC WRITTEN CONSENT OF WALT DISNEY IMAGINEERING.
CONTRACTOR SHALL VERIFY ALL CONDITIONS ON JOB SITE & NOTIFY THE THE PROJECT ENGINEER OF ANY VARIATIONS FROM DIMENSIONS SHOWN ON THESE DRAWINGS BEFORE PROCEEDING WITH ANY CONSTRUCTION.

KEY PERSONS AND APPROVALS
PROJECT MANAGER: DAVID WOOD
PROJECT DESIGN MANAGER: VAL USLE
PRODUCTION MANAGER: SUSAN BONDS
PRODUCTION DESIGNER: DAVID EDWINSTER
CREATIVE DIRECTOR: JOE LAPPERTON
CREATIVE:
APPROVED:
DATE: 9/29/93
Walt Disney Imagineering
1401 Flores Street
Burbank, CA 91521
(818) 544-6500

PROJECT DESIGNED FOR:
Disneyland®
ANAHEIM, CALIFORNIA

PROJECT AREA: ADVENTURELAND
UNIT NAME: INDIANA JONES EXPEDITIONS
WBS & TITLE: SCENE 8: MURALS
SHEET TITLE: THE SNAKE TEMPLE

PHASE: CD
PROJECT CODE NUMBER:
DRAWING NO.: D-8-06
REVISION NO.: △